


METRIC INFORMATION COMMENTED:
SHOWN IN THE PLAN AND NOTED IN THE CAUTION
SECTION OF THIS PLAN BY THE SURVEYOR.

Appendix B: Plan No. RC-H-896 Surveys

SKETCH SHOWING
REAR YARD WATERMAIN
SERVICING FOR
HOUSES #1009 to 1097
SCENIC DRIVE
SCALE = 1:800

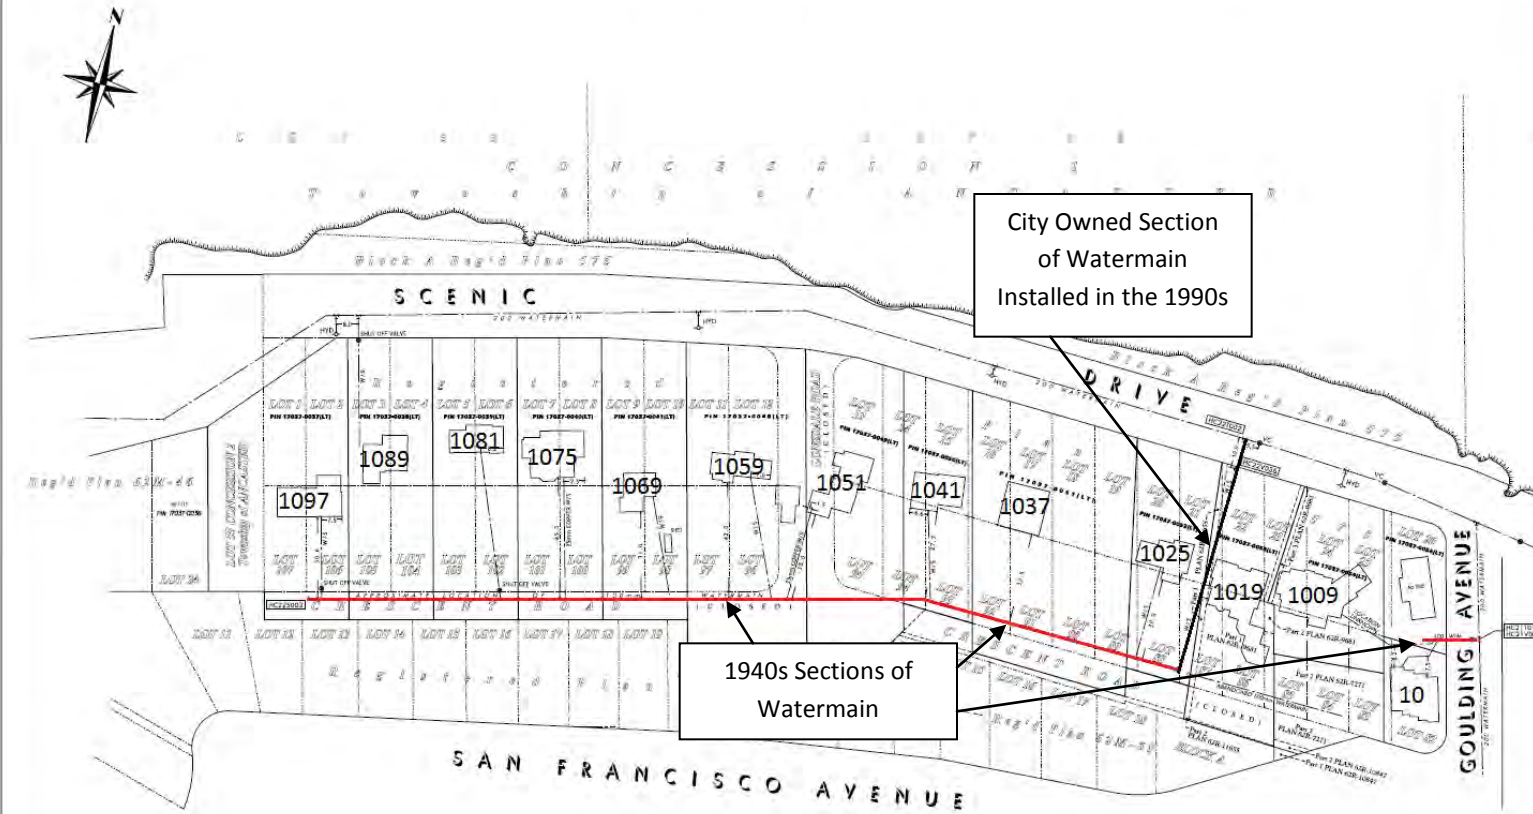

CAUTION
THIS IS NOT A PLAN OF SURVEY AND SHALL NOT BE USED
EXCEPT FOR THE PURPOSE INDICATED IN THE TITLE BLOCK

LEGEND
WB - SHOWS WATER SERVICES
Reg - DRAINS REGISTERED

NOTES
1. THIS SURVEY IS COMPILED FROM OFFICE INFORMATION
AND DATA COLLECTED DURING FIELD ATTENDANCE
COMPLETED ON THE 28th DAY OF APRIL, 2016.
2. THIS COPY IS THE PROPERTY OF THE CITY OF HAMILTON
AND IS PROTECTED BY COPYRIGHT.
3. A COPY OF THIS SKETCH IS NOT VALID UNLESS EMBOSSED
WITH THE SURVEYOR'S SEAL.

CITY OF HAMILTON
Geomatics and Corridor Management

FILE NO.	DATE	BY	DATE
PROJECT NO.	ISSUED BY	DATE	ISSUED BY

PLAN No. RC-H-896 SURVEYS

Note: This is a mark-up of Plan No. RC-H-896 as plotted by Surveys staff.