

SEAL:

issued or revised		
02	ISSUED WITH CORRECTIONS	2024-11-27
01	ISSUED FOR PRICING	2024-11-26
no.	description	date

PROJECT:

NEW VISION CHURCH -
MASONRY SAFETY CONCERNS

DRAWING:

LOW ROOF PLAN

DESIGNED BY:	JD
DRAWN BY:	JY
SCALE:	DATE:
NTS	2024-11-26
PROJECT No.	25040
DRAWING No.	SK-S1

EXTENT OF GABLES TO BE
NETTED, TYP (4 TOTAL). WRAP
NETTING UP AND OVER GABLE
AND SECURE TO STEEL ROOF
STRUCTURE BEHIND. AT SIDES,
SECURE TO BACKUP MASONRY.

GABLE END TO BE LOCALLY
REBUILT WITH NEW BRICK,
INCLUDING RESETTING TWO
LOOSE COPING STONES, PRIOR
TO NETTING.

EXTENT OF PIERS TO BE
NETTED, TYP (9 TOTAL). WRAP
TIGHT AROUND ALL SIDES AND
SECURE WITH CABLE TIES.

EXISTING TURRET TO BE
INVESTIGATED VIA LIFT AND
POTENTIALLY DISMANTLED
DOWN TO ROOF LEVEL AS
NOTED IN LETTER. PROVIDE
SEPARATE PRICE FOR THIS
WORK.

PROVIDE OVERHEAD
PROTECTION, CONSISTING OF
SCAFFOLD FRAMES AND
SCAFFOLD DECKING BETWEEN
DOOR AND FENCE.

FENCE ACROSS ALLEYWAY, IN
LINE WITH PIER AT CHURCH
WALL, TO PREVENT ACCESS
FOR MIN 8' FROM GABLE WALL.

ADJACENT
BUILDING

NOTE: ALL CURRENT WORK IS
SHOWN IN RED. BLACK &
WHITE BACKGROUND IS TAKEN
FROM DRAWINGS FOR 1990'S
ADDITION.

ADDITION ROOF &
EXISTING 2nd FLOOR PLAN
1/8" = 1'-0"

issued or revised

02	ISSUED WITH CORRECTIONS	2024-11-27
01	ISSUED FOR PRICING	2024-11-26
no.	description	date

NEW VISION CHURCH -
MASONRY SAFETY CONCERNS

WEST ELEVATION


JD

JY

4-11-26

25040

SK-S2

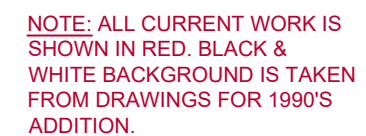

SEAL:

issued or revised		
02	ISSUED WITH CORRECTIONS	2024-11-27
01	ISSUED FOR PRICING	2024-11-26
no.	description	date

PROJECT:

**NEW VISION CHURCH -
MASONRY SAFETY CONCERNS**

DRAWING:

EAST ELEVATION

DESIGNED BY: JD


DRAWN BY: JY

SCALE: NTS DATE: 2024-11-26

PROJECT No. 25040

DRAWING No.

SK-S3

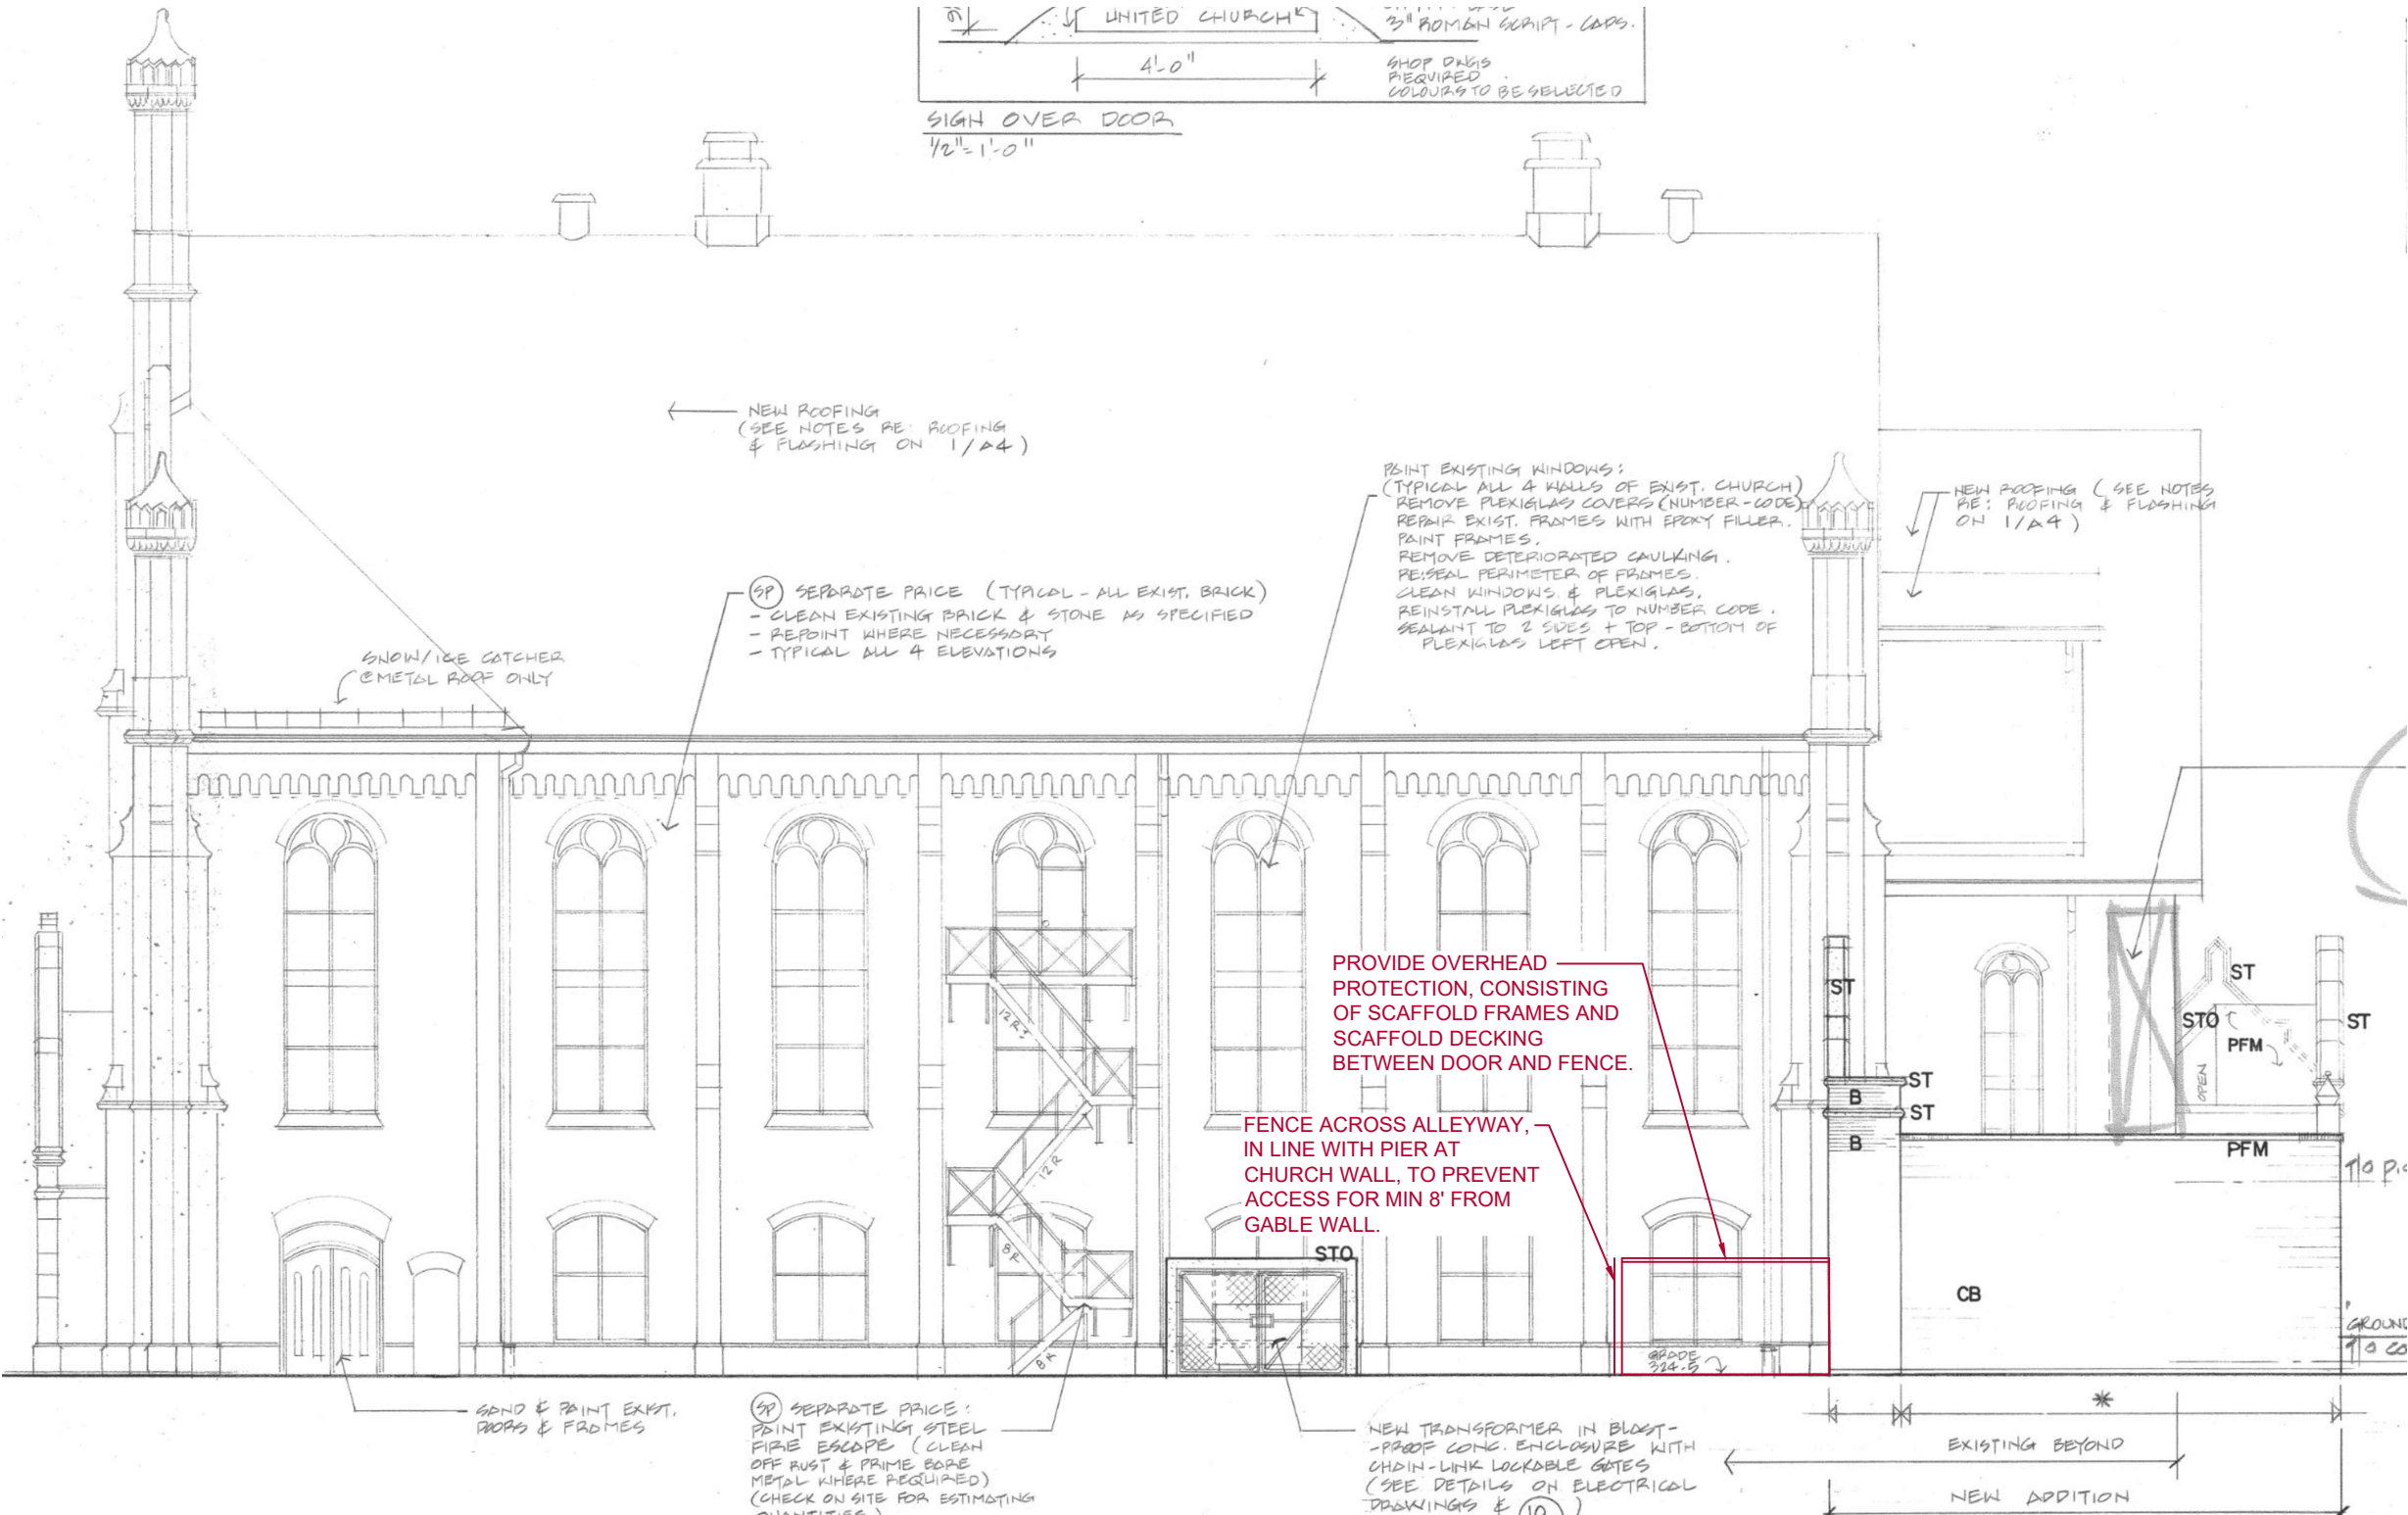

SEAL:

issued or revised		
02	ISSUED WITH CORRECTIONS	2024-11-27
01	ISSUED FOR PRICING	2024-11-26
no.	description	date

PROJECT:

**NEW VISION CHURCH -
MASONRY SAFETY CONCERNS**

DRAWING:

SOUTH ELEVATION

DESIGNED BY: JD


DRAWN BY: JY

SCALE: NTS DATE: 2024-11-26


PROJECT No. 25040

DRAWING No.

SK-S4

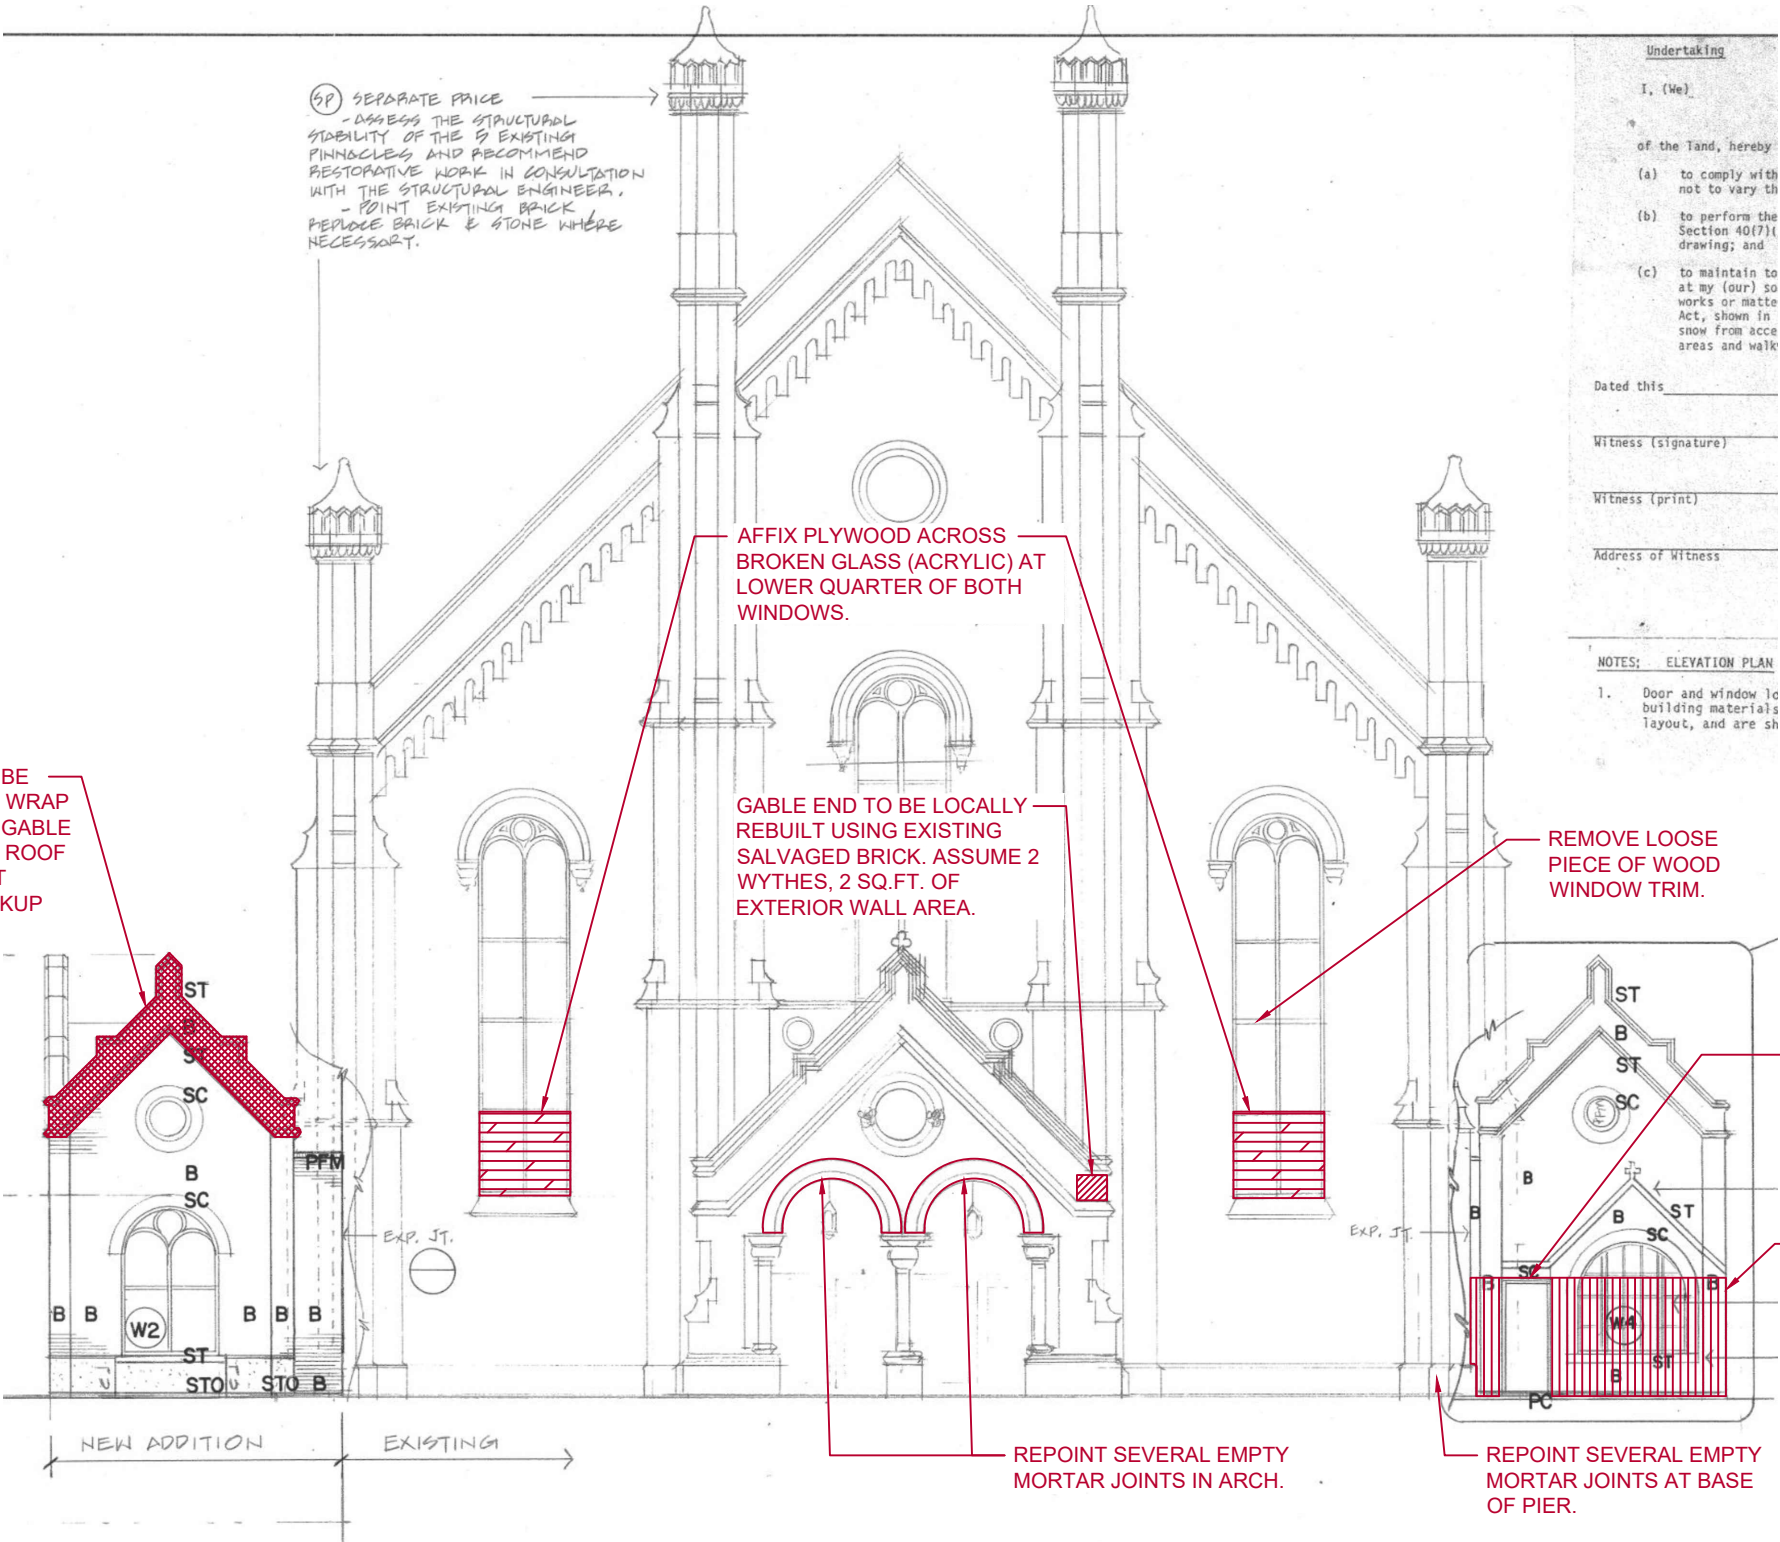

ITION AND QUANTITIES FOR
PDA / REPLACEMENT WORK
IDS, SURFACES, COMPONENTS,
2 PREPARE ESTIMATES

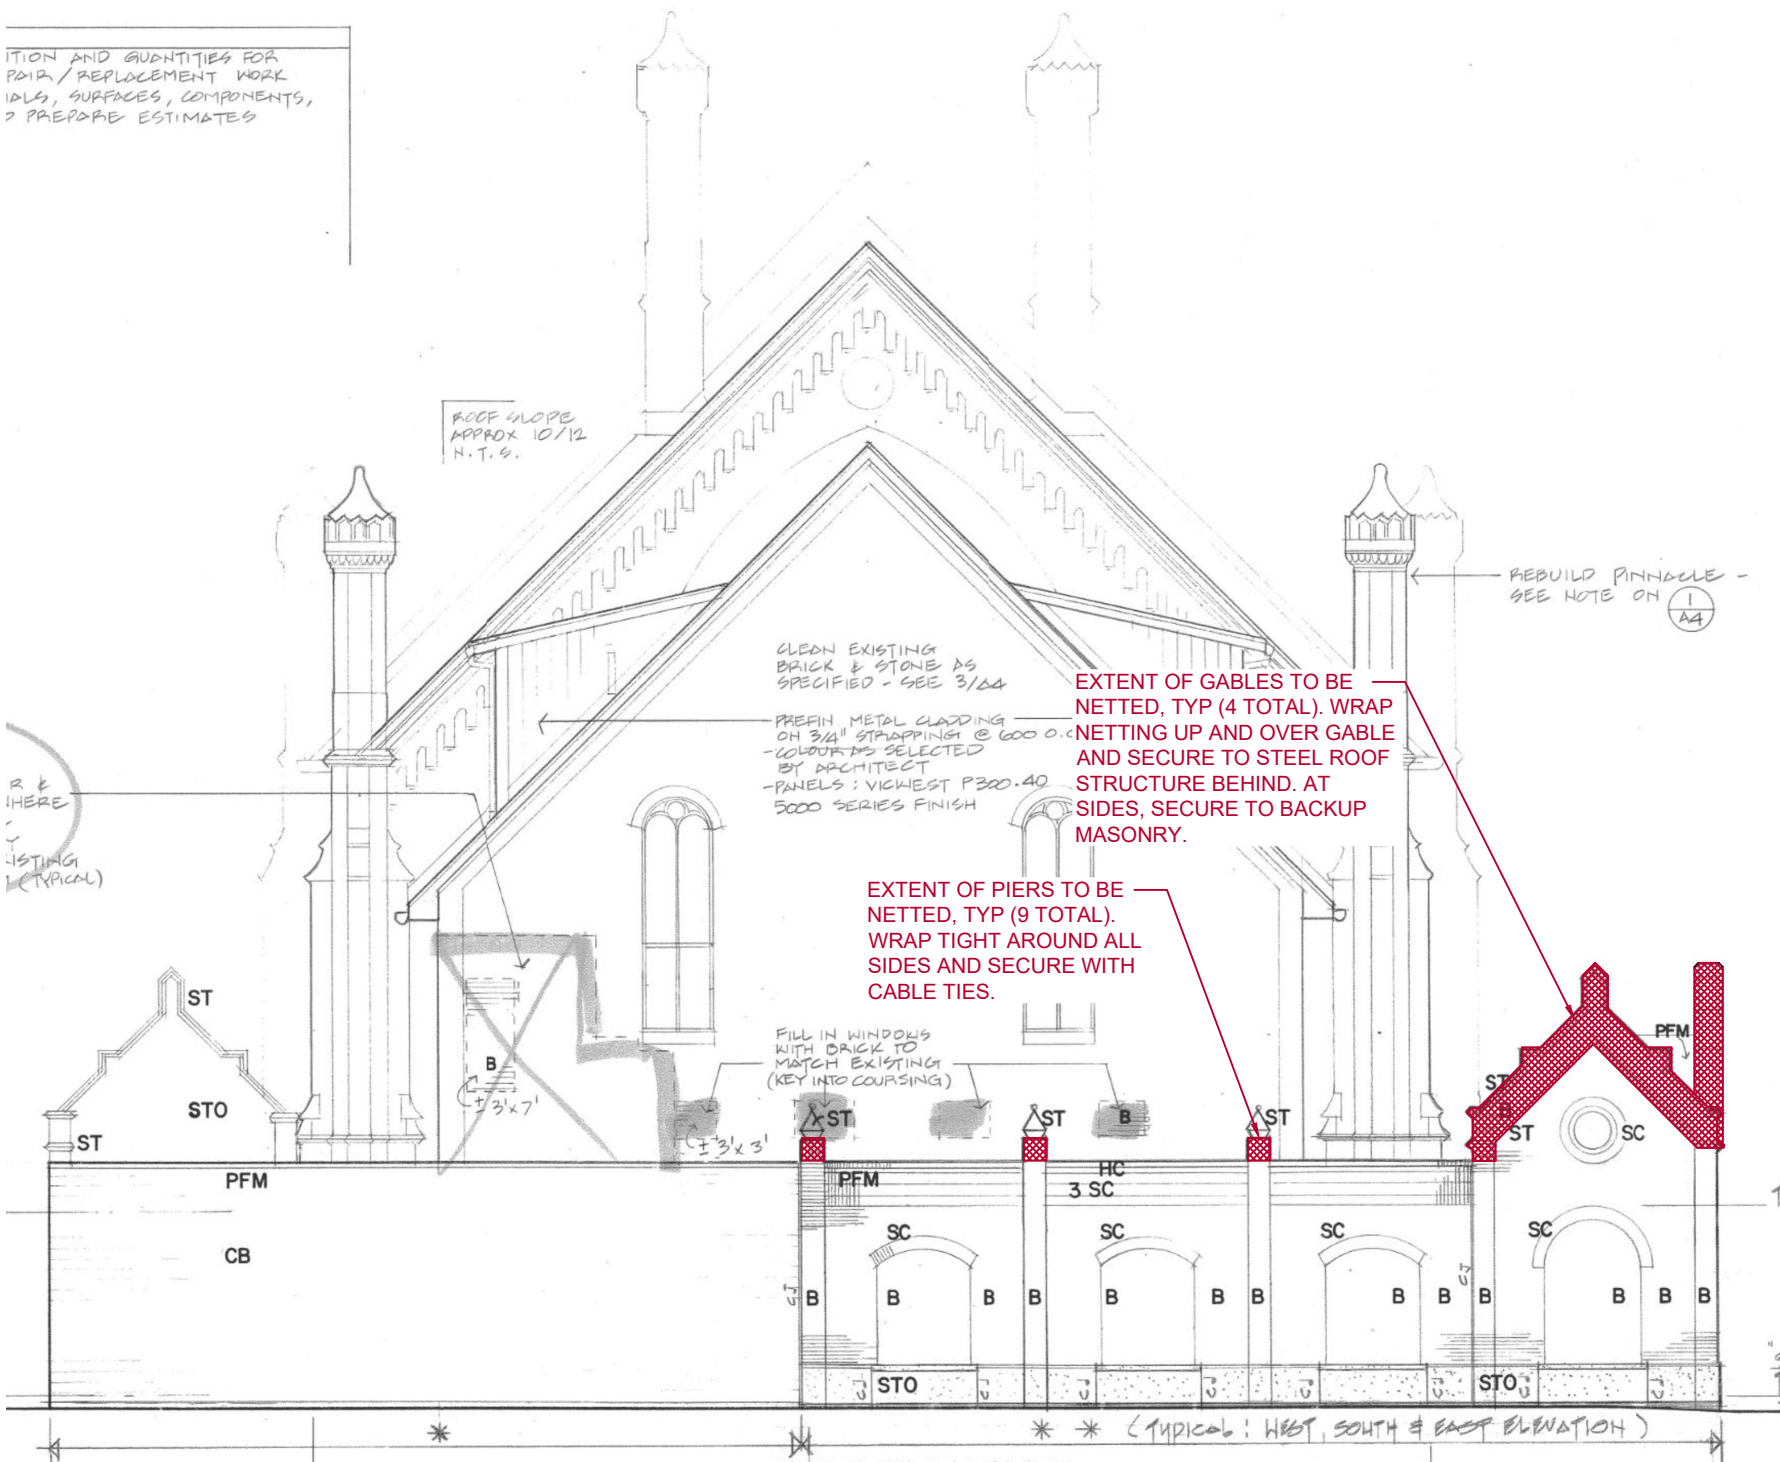

NOTE: ALL CURRENT WORK IS
SHOWN IN RED. BLACK &
WHITE BACKGROUND IS TAKEN
FROM DRAWINGS FOR 1990'S
ADDITION.

SEAL:

issued or revised		
02	ISSUED WITH CORRECTIONS	2024-11-27
01	ISSUED FOR PRICING	2024-11-26
no.	description	date

PROJECT:

NEW VISION CHURCH -
MASONRY SAFETY CONCERNS

DRAWING:

NORTH ELEVATION

DESIGNED BY:	JD
DRAWN BY:	JY
SCALE:	DATE:
NTS	2024-11-26
PROJECT No.	25040
DRAWING No.	

SK-S5

SEAL:

issued or revised		
02	ISSUED WITH CORRECTIONS	2024-11-27
01	ISSUED FOR PRICING	2024-11-26
no.	description	date

PROJECT:


NEW VISION CHURCH -
MASONRY SAFETY CONCERNS

DRAWING:

DETAILS


DESIGNED BY:	JD
DRAWN BY:	JY
SCALE:	DATE:
NTS	2024-11-26
PROJECT No.	25040
DRAWING No.	

SK-S6

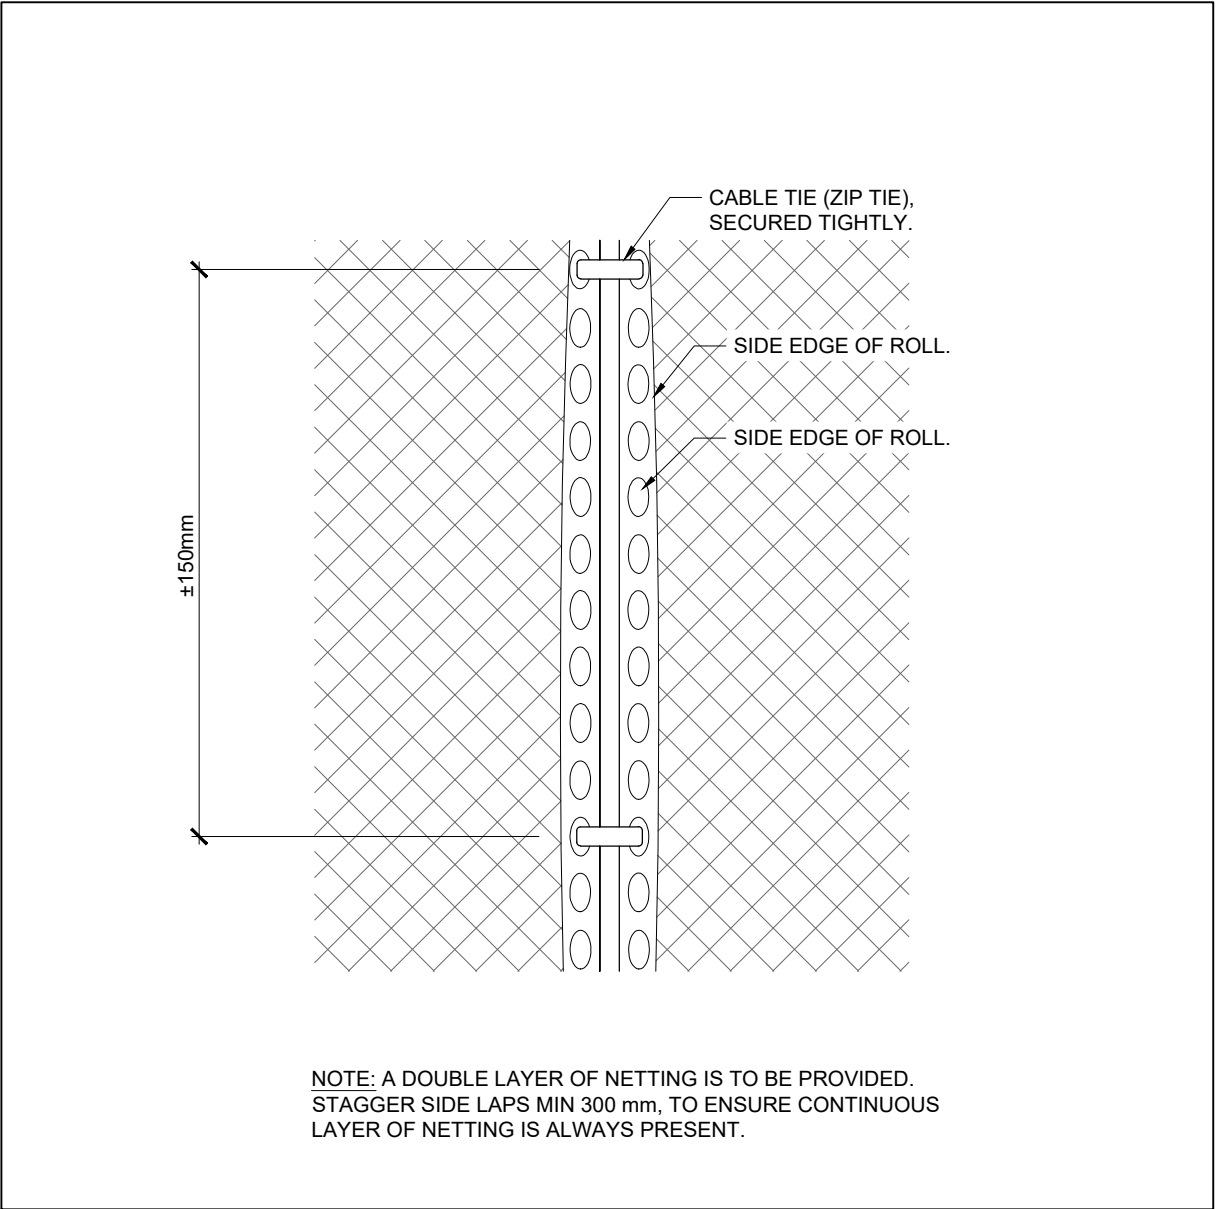

1
SK-S6 NTS

DETAIL - NETTING VERTICAL JOINT

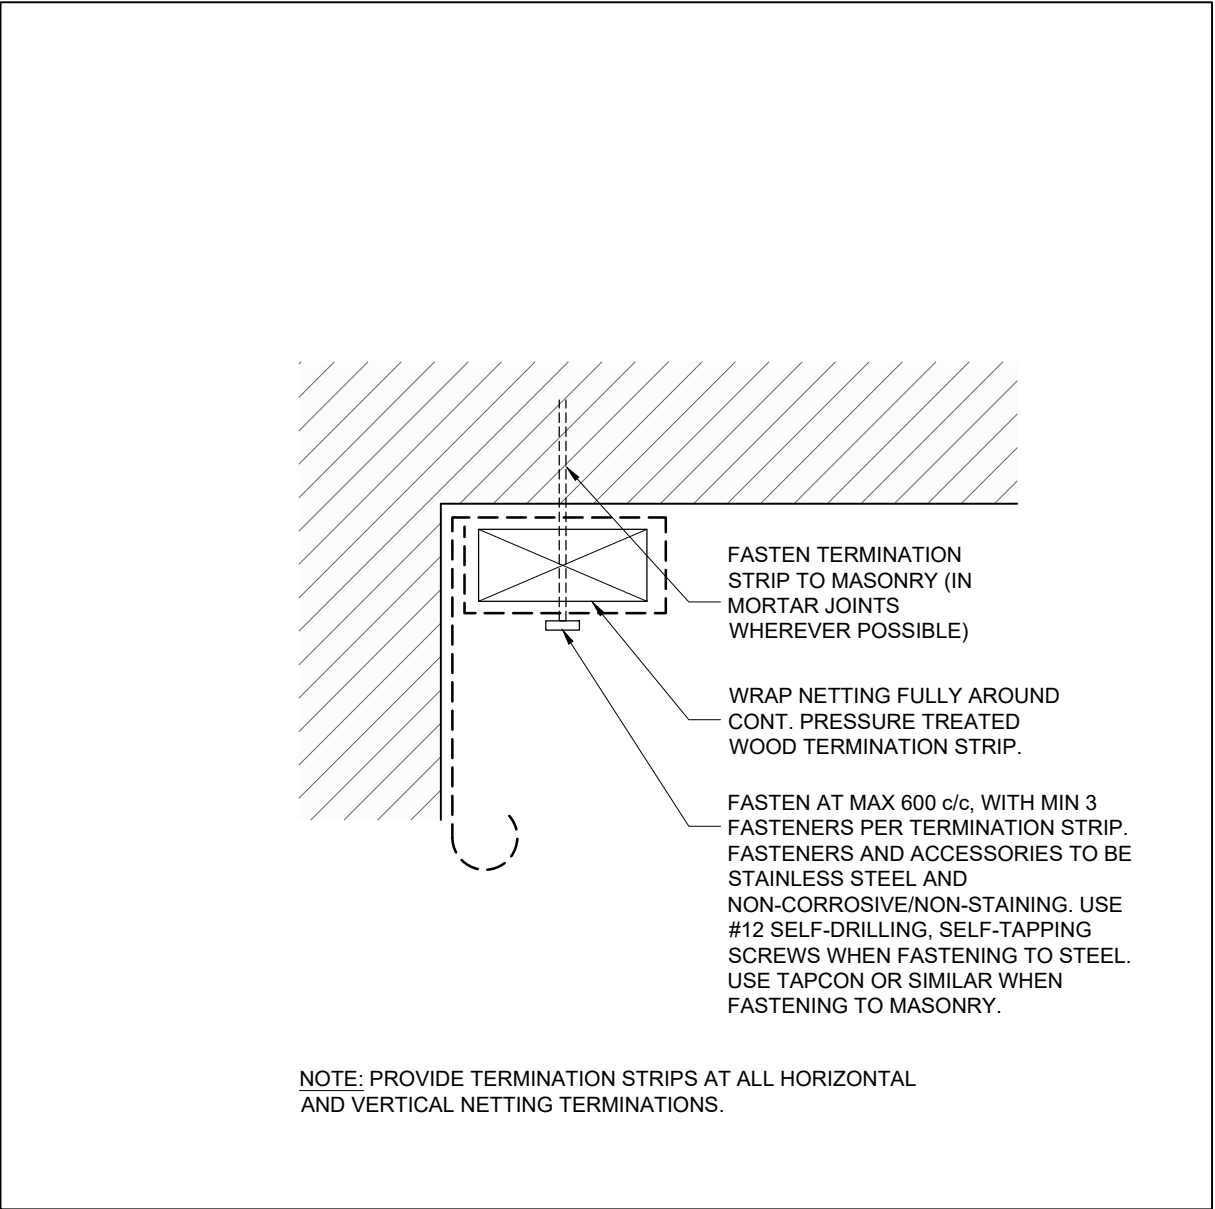

2
SK-S6 NTS

DETAIL - NETTING TERMINATION

SEAL:

issued or revised		
02	ISSUED WITH CORRECTIONS	2024-11-27
01	ISSUED FOR PRICING	2024-11-26
no.	description	date

PROJECT:


NEW VISION CHURCH -
MASONRY SAFETY CONCERNS

DRAWING:

DETAILS

DESIGNED BY:	JD
DRAWN BY:	JY
SCALE:	DATE:
NTS	2024-11-26
PROJECT No.	25040
DRAWING No.	

SK-S7

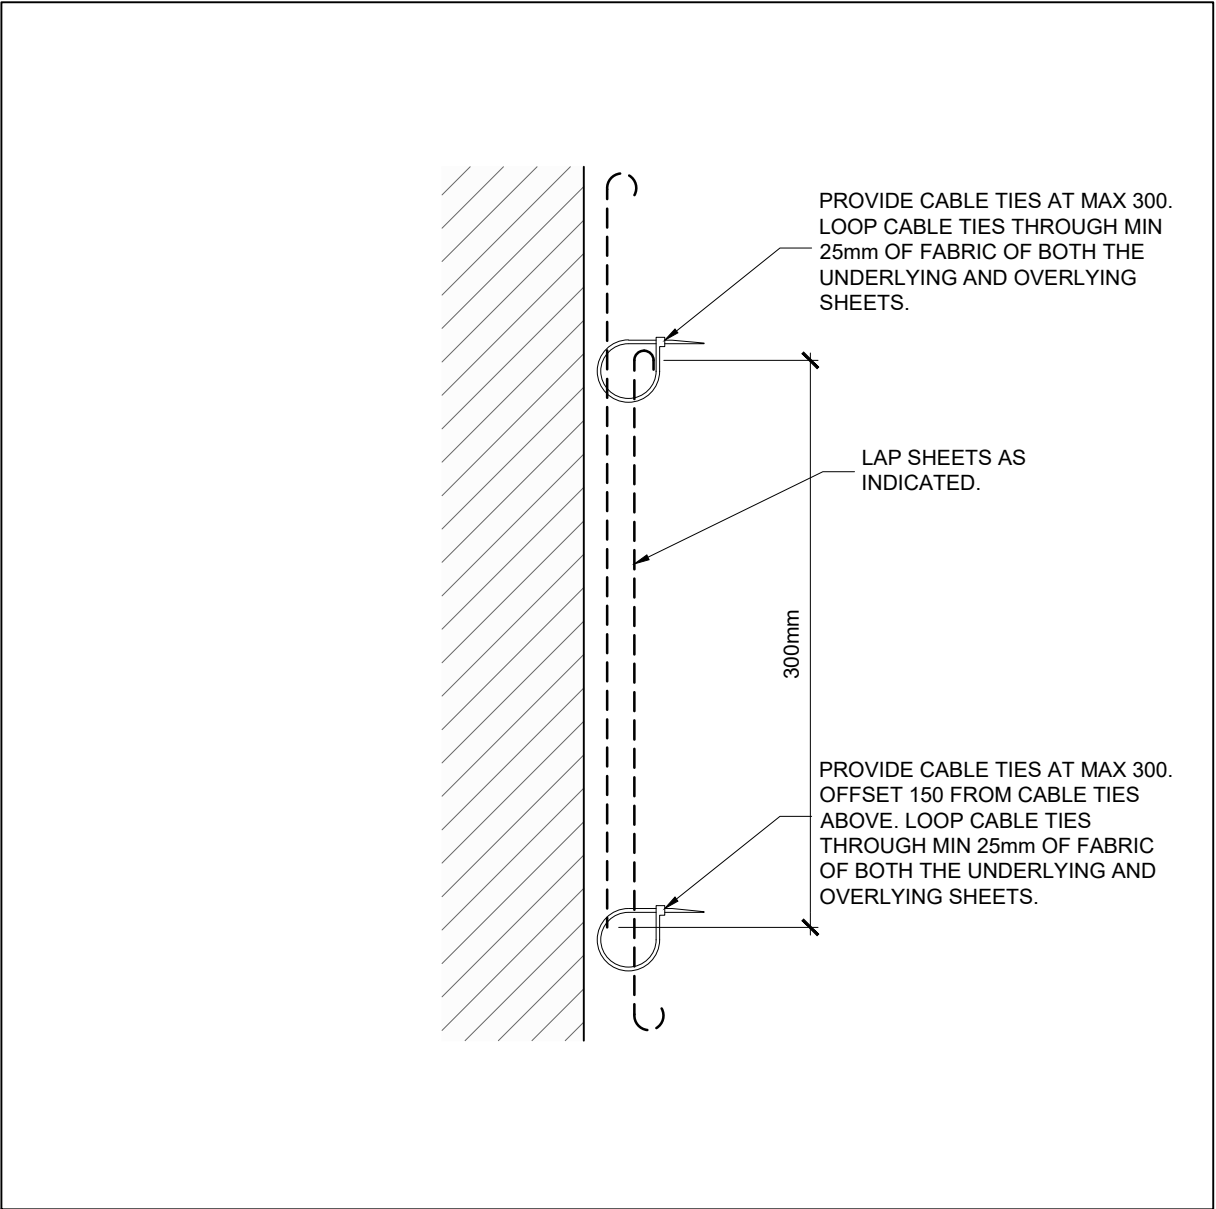

1
SK-S7 NTS

DETAIL - NETTING AT HORIZONTAL JOINT